

ADDENDUM NO. 1

JOHN CAIN SEWER LINE REPLACEMENT PROJECT May 9, 2018

The contract documents for the above-referenced project are hereby modified or explained further as follows:

ADDITION

1. Project Special Provisions (SP) SP-05 Time of Completion is revised as follows:

All work under this contract shall reach final completion within forty (40) calendar days **from the Contractor's selected Start Date.**

The planned construction Start Date for this Project is June 4, 2018, subject to weather and ground conditions. **If Contractor chooses to begin work later than June 4, 2018, he/she shall notify the District of the Contractor's selected Start Date, in advance of June 4, 2018, and shall provide a schedule in accordance with SP-24, demonstrating the ability to complete the work by October 15, 2018.**

No work shall be performed the week of July 4th (June 30th to July 8th); this time will not be counted against the ~~Contractor~~ **contract working days.**

Contractor's attention is directed to SP-19 and Part IX Appendices with respect to the Limited Right of Entry Agreement and Access Agreement (Agreement) with the Talmont Resort Improvement District (TRID). Use of the TRID parcel for construction staging and storage is limited to a continuous 40 day period between June 1, 2018 and October 1, 2018, in accordance with the Agreement.

No grading or land disturbance shall be performed between October 15th and May 1st, unless specifically approved, as provided elsewhere in these Specifications.

REVISION

The sewer service for the residential property located at 438 John Cain Road (APN 083-340-014; southeast corner of Silvertip Drive and John Cain Road) is being included in the Project, via this addendum. The work includes abandonment of the sewer service within the public utility easement (PUE) and at the main in Silvertip Drive. The new sewer service connection includes installation of a double cleanout at limit of the PUE and connection to the new 6-inch sewer line at STA 1+32, as show on plan sheet C1R, attached. The following revisions are included:

1. Construction Drawing Sheet C1: remove existing Sheet C1 and replace with attached sheet C1R.
2. Bid Proposal Form: remove existing Bid Schedule (Bid Proposal Form page 6) and replace with attached Bid Schedule.

The foregoing requirements are in modification of and supplemental to the original contract documents, and in case of conflict, shall govern. All other provisions of the contract documents remain unchanged, and shall be in effect.

Bid Addendum No. 1
John Cain Sewer Line Replacement Project
May 9, 2018
Page 2 of 2

Bidders shall acknowledge receipt of this Addendum and other Addenda issued in the blanks provided on the Bid Proposal Form. Bidders who fail to acknowledge this Addendum in the manner specified may have bid proposals rejected.


Sincerely,

A handwritten signature in blue ink, appearing to read "Sarah Hussong Johnson". The signature is fluid and cursive, with a large initial "S" and "J".

Sarah Hussong Johnson, P.E.
Associate Civil Engineer

cc: All Planholders


Attachments: Construction Drawing C1R
Bid Schedule

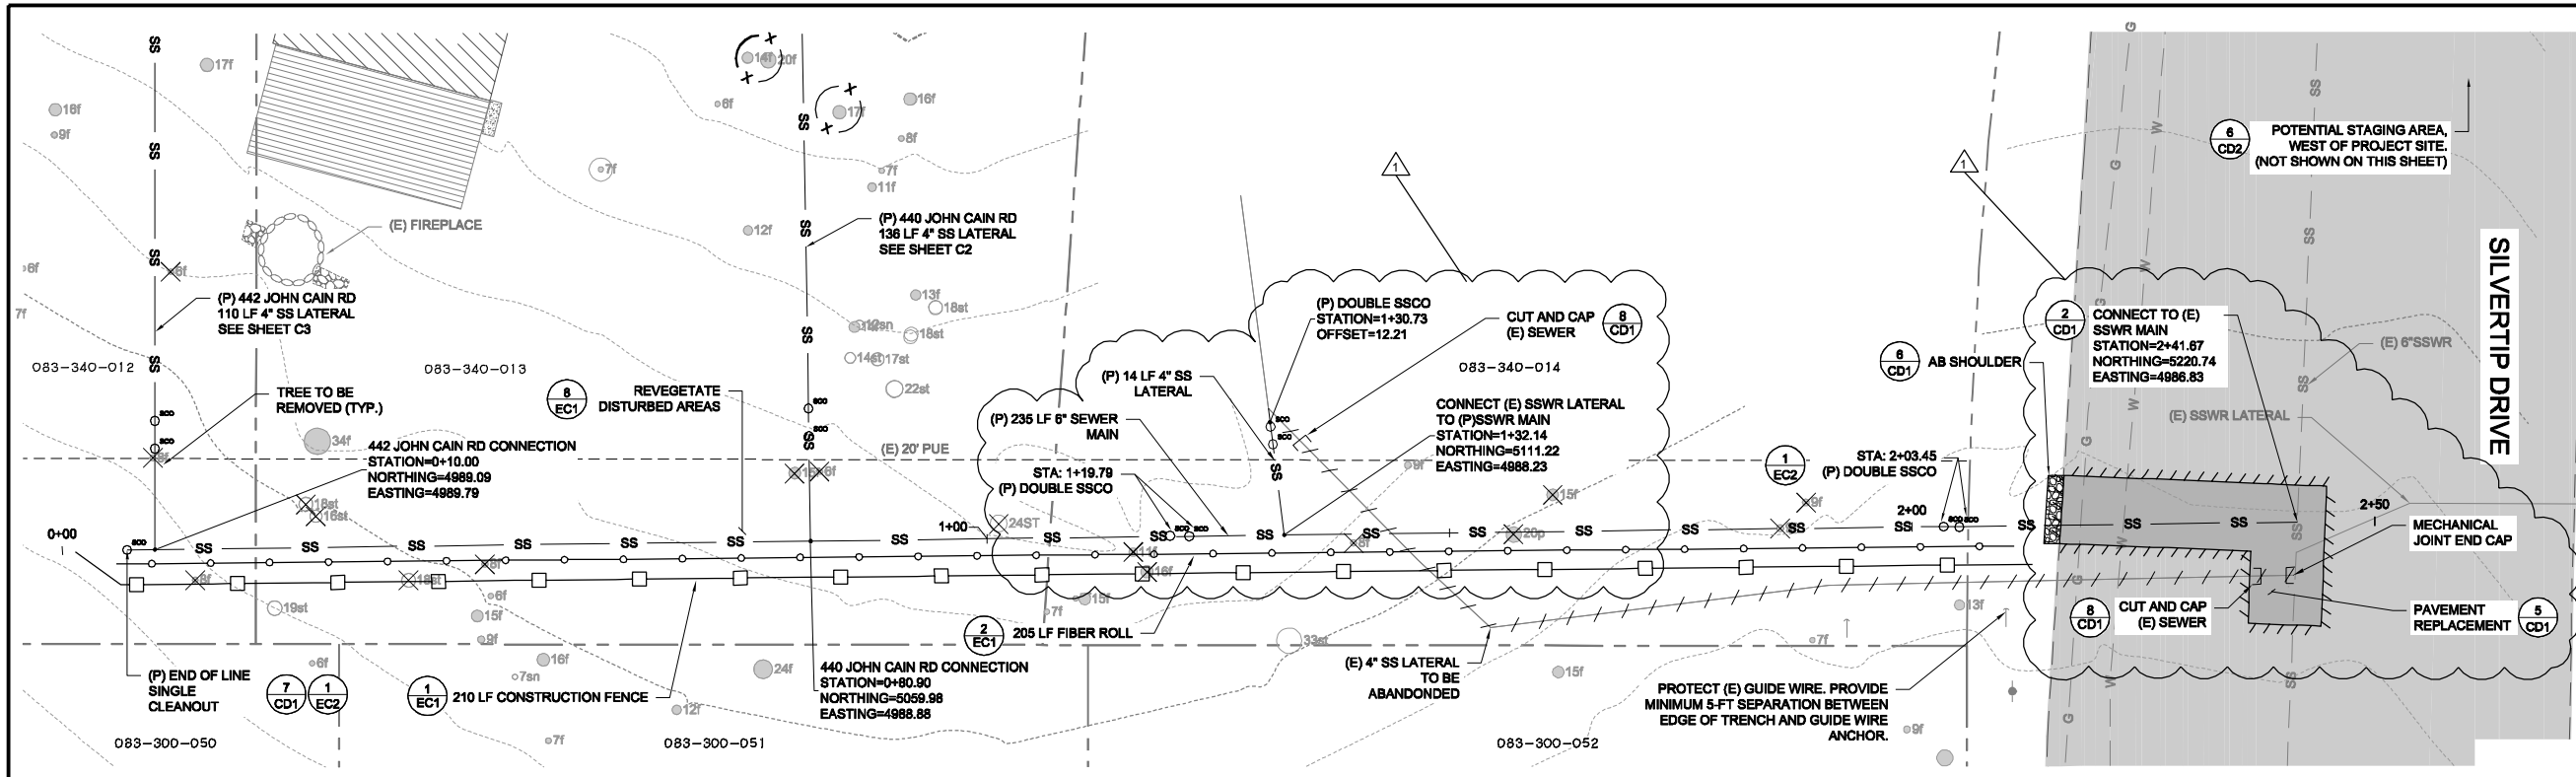

PLAN

SCALE: 1"=10'

- NOTES:**
1. ACTUAL DEPTH AND LOCATION OF (E) CROSSING ELECTRIC, GAS, TELE, AND WATER UTILITIES SHOWN ARE UNKNOWN. THEY WERE NOT POTHOLED. CONTRACTOR SHALL POTHOLE TO DETERMINE ACTUAL DEPTH AHEAD OF TRENCHING AND AVOID AND PROTECT.
 2. REFER TO EROSION CONTROL NOTES ON SHEET EC1 AND PART III OF THE SPECIFICATIONS FOR REVEGETATION AND RESTORATION REQUIREMENTS OF UNPAVED AREAS.
 3. PROTECT EXISTING UTILITIES THROUGHOUT CONSTRUCTION.

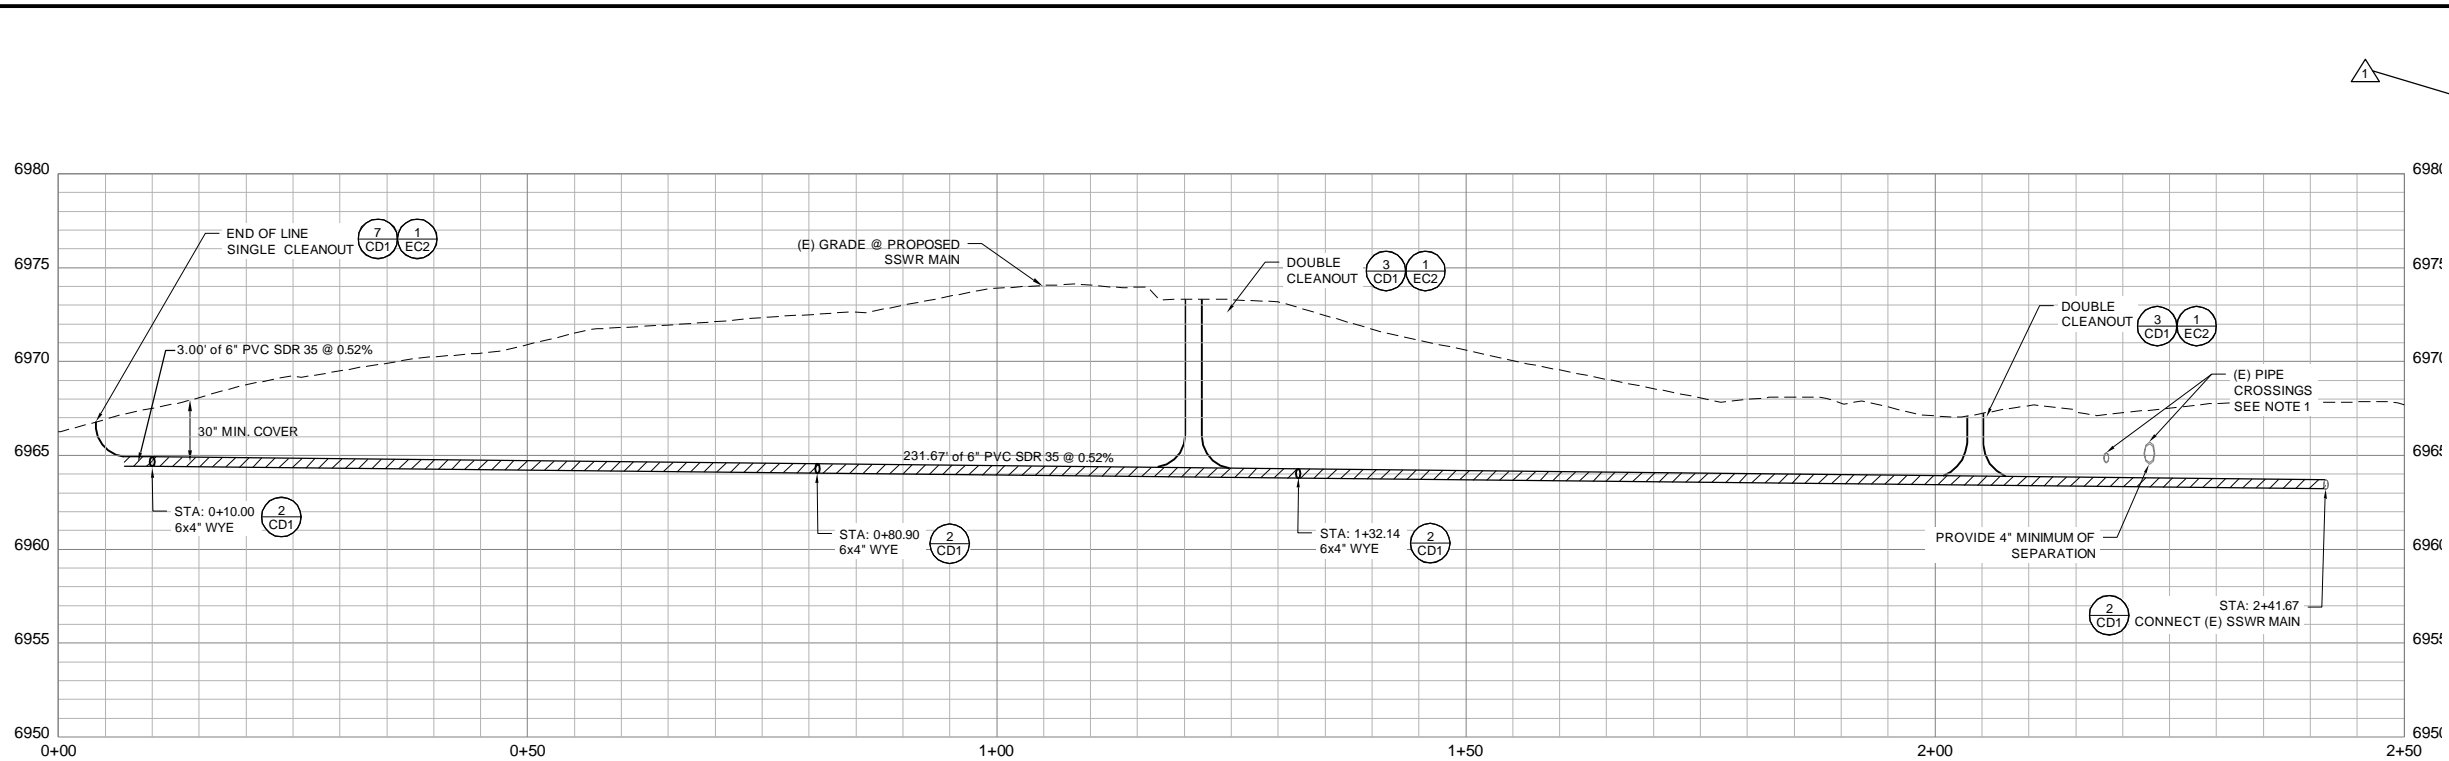


PROFILE

SCALE: 1"=10' (H) 1"=5' (V)

TREE DEMO TABLE

Tree No.	Tree Size & Type
1	8F
2	8F
3	15F
4	20P
5	8F
6	16F
7	11F
8	8F
9	15F
10	8F
11	8F
12	8F
13	8F

* TREE REMOVAL TABLE FOR ENTIRE PROJECT. DOES NOT INCLUDE STUMPS

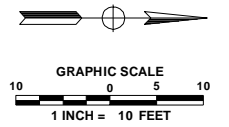


THE CONTRACTOR SHALL CALL "UNDERGROUND SERVICE ALERT (USA)" AT (800) 642-2444 TWO (2) DAYS MINIMUM TO FOURTEEN (14) DAYS MAXIMUM PRIOR TO COMMENCING EXCAVATION.

BY	DATE	REVISIONS
JM		

RECORD DRAWING

DATE _____ ENGINEER INITIAL _____

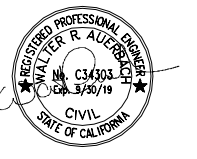

AUERBACH ENGINEERING CORP.
 CIVIL ENGINEERING • LAND SURVEYING • ENVIRONMENTAL PLANNING
 PROGRAM MANAGEMENT AND PLANNING
 P.O. BOX 5338 • 642 W. LAKE BLVD. • TAHOE CITY, CALIFORNIA 96145
 VOICE (530) 591-1116 • FAX (530) 518-1312
 WWW.AUERBACHENGINEERING.COM

REUSE OF DOCUMENTS
 THIS DOCUMENT & THE IDEAS & DESIGNS INCORPORATED HEREIN AS AN INSTRUMENT OF PROFESSIONAL SERVICE, IS THE PROPERTY OF AEC & IS NOT TO BE USED, IN WHOLE OR IN PART, FOR ANY OTHER PROJECT WITHOUT THE WRITTEN AUTHORIZATION OF AEC.

TAHOE CITY PUBLIC UTILITY DISTRICT
JOHN CAIN SEWER LINE REPLACEMENT PROJECT
SEWER MAIN PLAN & PROFILE
STA: 0+00 - 2+50
 TAHOE CITY PLACER COUNTY CALIFORNIA

PROJECT NUMBER:	2201C
SURVEY DATE:	AEC
DESIGN DATE:	9/29/2017
DRAFTING BY:	JM
CHECKED BY:	WRA
DATE:	MAY 9, 2018

SCALES:
 AS SHOWN
 HORIZONTAL
 AS SHOWN
 VERTICAL

C1R

SHEET: 3 of 9

J:\22.01C\Drawings\Final Sheets\22.01C_C1R.dwg

Tahoe City Public Utility District
JOHN CAIN SEWER LINE REPLACEMENT PROJECT
BID PROPOSAL FORM
(Continued)

BID SCHEDULE

Item No.	Description	Quantity	Unit	Unit Cost (\$/Unit)	Total Cost (\$) ⁽¹⁾
1	Mobilization / Demobilization (5%)	1	LS	\$	\$
2	Temporary Erosion Controls/Tree Protection	1	LS	\$	\$
3	Demolition	1	LS	\$	\$
4	Shoring and Worker Safety	1	LS	\$	\$
5	Traffic Control	1	LS	\$	\$
6	Dewatering	1	LS	\$	\$
7	Connect to (E) Sewer Main	1	EA	\$	\$
8	Service Lateral (4" PVC SDR 35)	262	LF	\$	\$
9	Sewer Main (6" PVC SDR 35)	235	LF	\$	\$
10	Single Cleanout	5	EA	\$	\$
11	Double Cleanout	5	EA	\$	\$
12	Site Restoration and Revegetation	1	LS	\$	\$
13	Pavement Restoration	580	SF	\$	\$
TOTAL BID ⁽²⁾ (in figures) Items 1 through 13				\$	
TOTAL BID (in writing) Items 1 through 13					

1. In the event that the product of a unit price and an estimated quantity does not equal the extended amount stated, the unit price will govern and the correct product of the unit price and the estimated quantity shall be deemed to be the amount of the bid.
2. In the event that the sum of the Total Cost does not equal the Total Bid amount stated, the actual sum of each Total Cost shall be deemed to be the amount of the bid.